
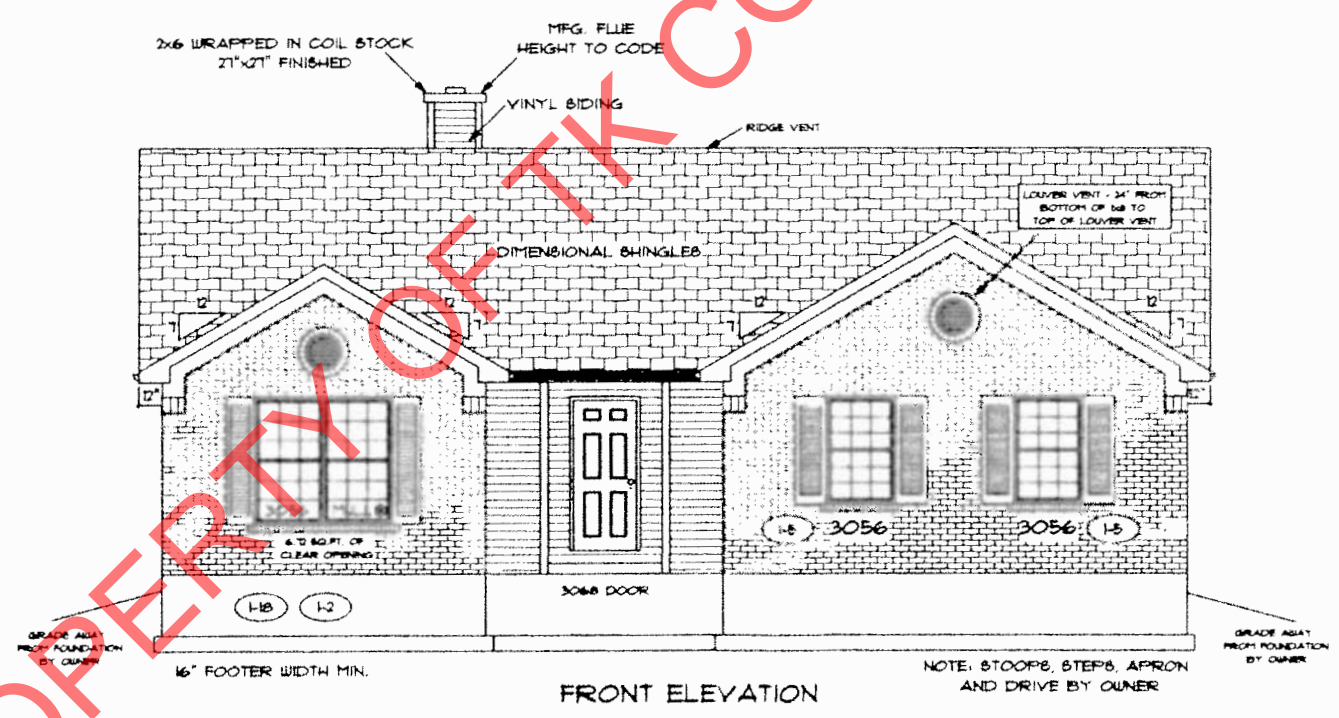


marked up 6-25-15

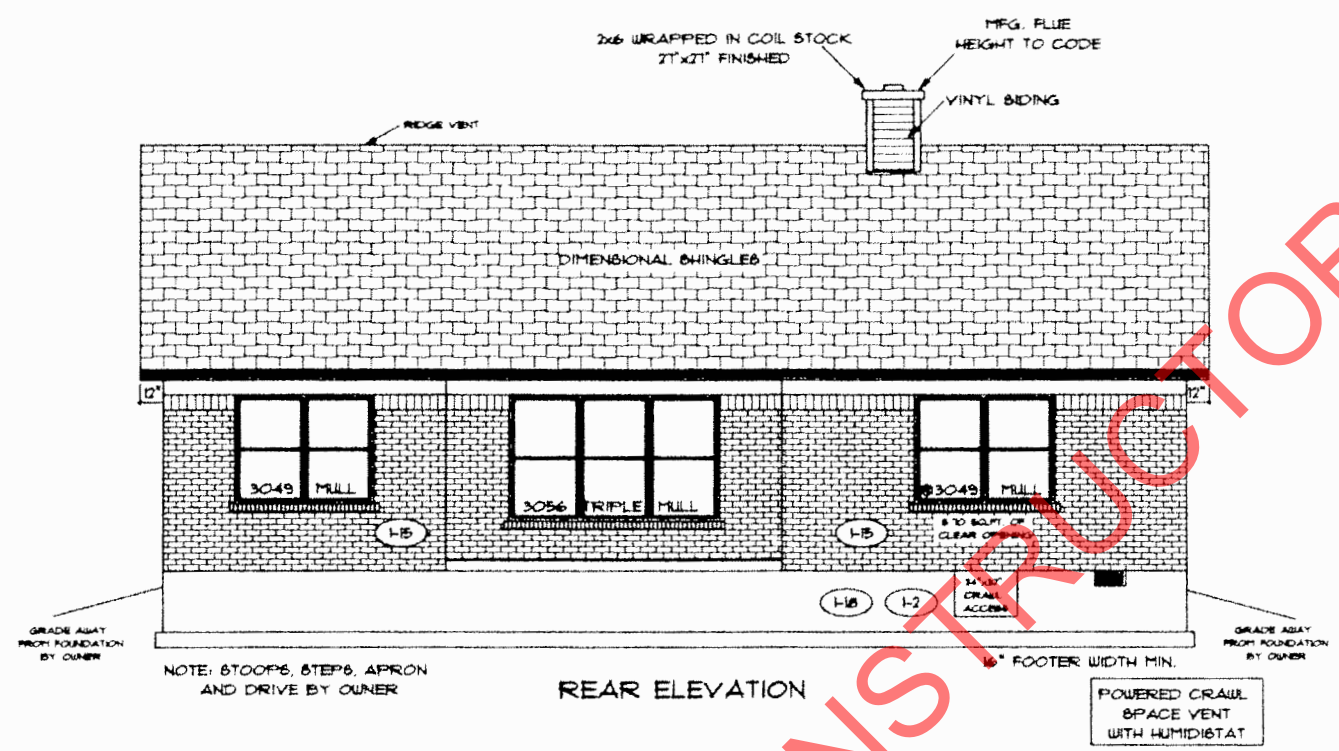

PROPERTY OF TK CONSTRUCTORS, INC

MODEL: ROCKFORD	PAGE NO.: 10
VER: 072210	
DRAWING BY: GW	
1/8" = 1'	
DATE: April 06, 2015	
JOB NO.: 212-15-0431	


TK CONSTRUCTORS

Handwritten initials/signature

FLOOR PLAN

Total Living Sq.ft.	1,581
Garage	472
Total Sq.ft.	2,053
Excluding Front Porch	19
Excluding Rear Porch	150

ANDERSEN WINDOWS	
MODEL	R.O. SIZE
3030	36" x 36"
3040	36" x 48"
3048	36" x 57"
3056	36" x 66"
3060	36" x 72"
3049 MULL	13" x 57"
3056 MULL	13" x 66"
3060 MULL	13" x 72"
ANDERSEN SLIDING DOOR	
R.O. 12 3/4" x 82 7/8"	
3/0 FRONT DOOR	
R.O. 3'-2 1/2" x 82 1/2"	
3/0 FRONT DOOR WITH (1) SIDE LIGHT	
R.O. 4'-3 1/2" x 82"	
3/0 FRONT DOOR WITH (2) SIDE LIGHTS	
R.O. 5'-5" x 82"	
R.O. FOR BYFOLD DOORS USING DRY-WALL JAMB FACING 16 1/4" DOOR SIZE	
R.O. FOR BYPASS DOORS USING DRYWALL JAMB FACING MAKE SAME AS BOTH DOORS ADDED TOGETHER	
ALL INTERIOR DOORS	
SIZE = 2" TO WIDTH x 82 1/2" HIGH	
R.O. POCKET DOOR - (2x DOOR WIDTH + 1") x 85" HIGH	

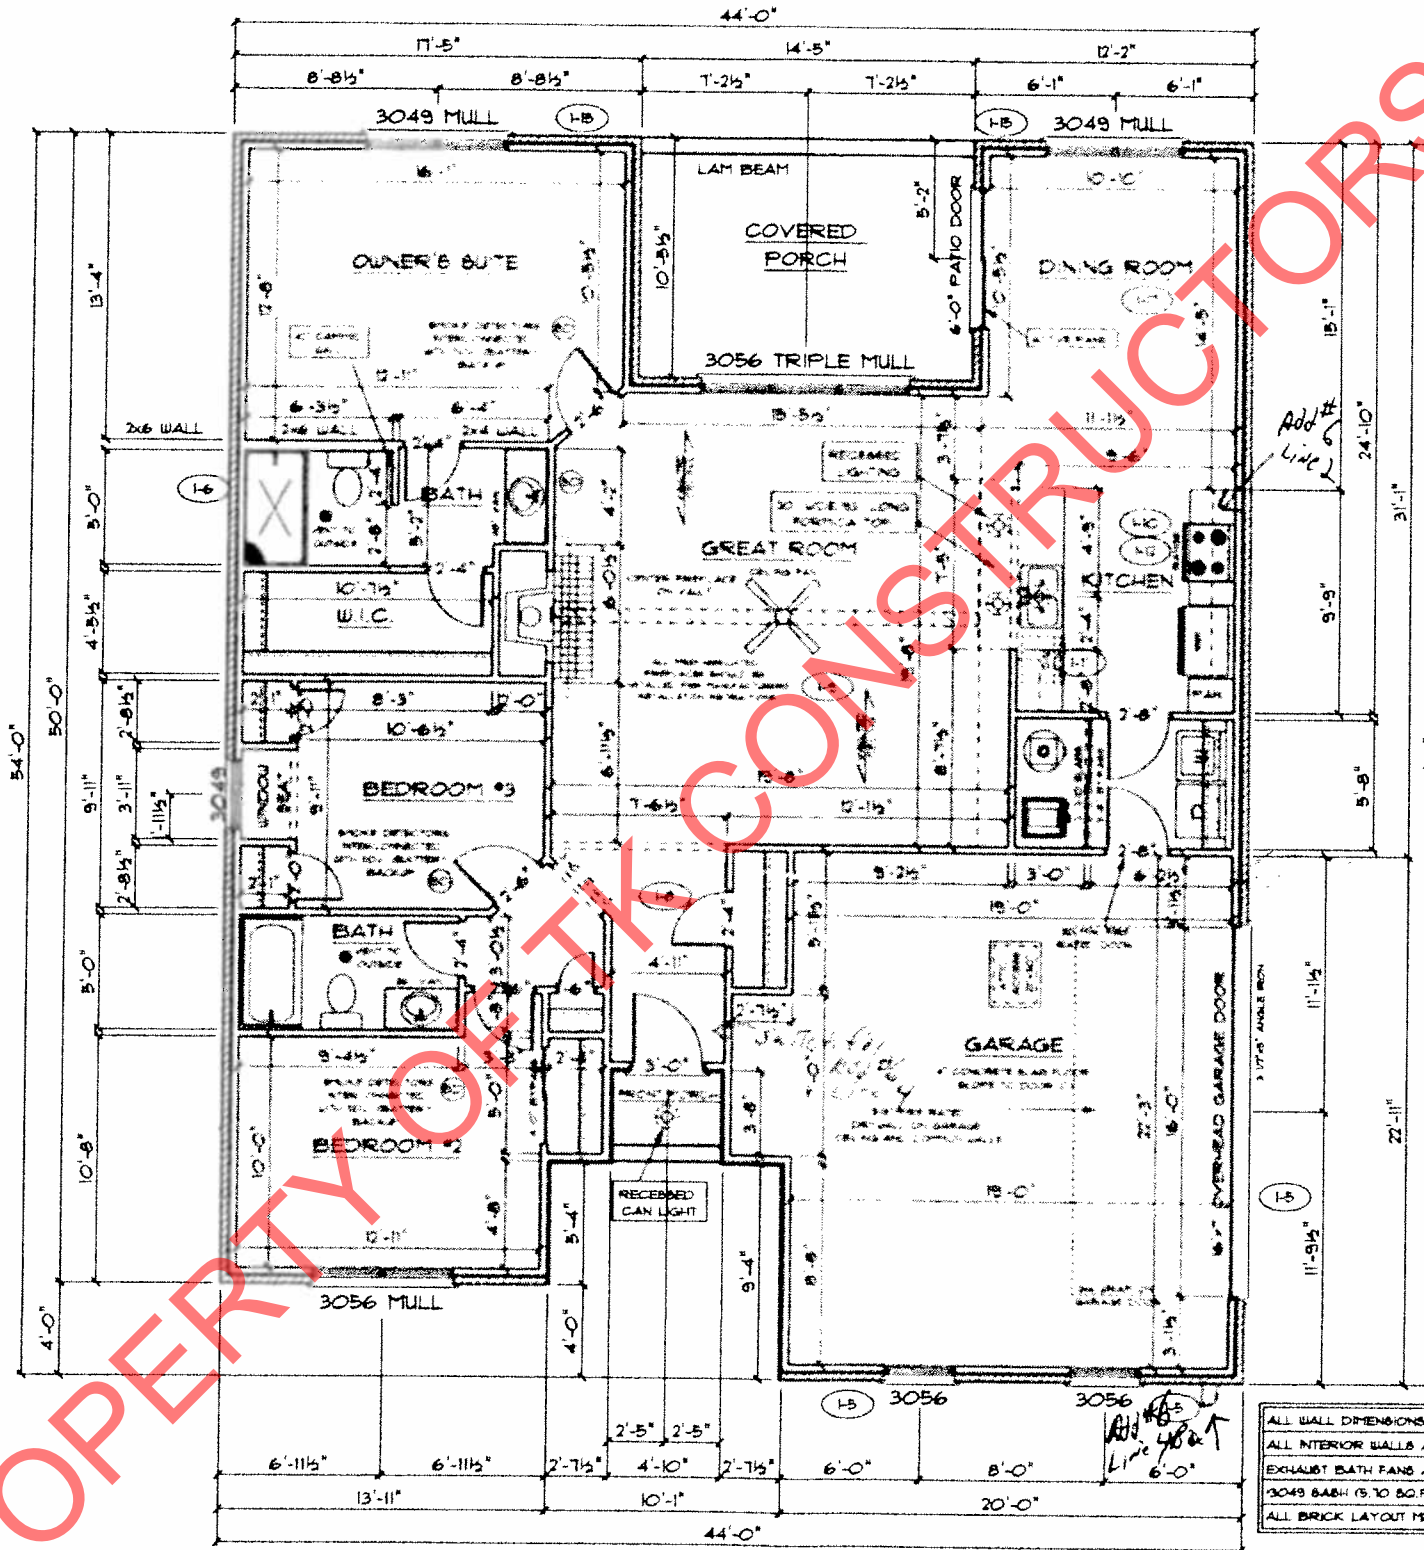

ALL WALL DIMENSIONS ARE FACE TO FACE OF STUDS
 ALL INTERIOR WALLS ARE 5/8" (UNLESS NOTED)
 EXHAUST BATH FANS ARE VENTED TO OUTSIDE AIR
 3049 BASH (5 TO 80 FT. OF CLEAR OPENING)
 ALL BRICK LAYOUT MEASUREMENTS ARE 4"

PROPERTY OF TK CONSTRUCTORS, INC

Handwritten initials/signature

	DATE: April 06, 2015 JOB NO.: 212-15-0431	MODEL: ROCKFORD VER: 072210 DRAWING BY: GW 1/8" = 1' CONSTRUCTORS
TK CONSTRUCTORS		PAGE NO.: 30