


Original
marked up for P.O.
6-14-16



REAR ELEVATION

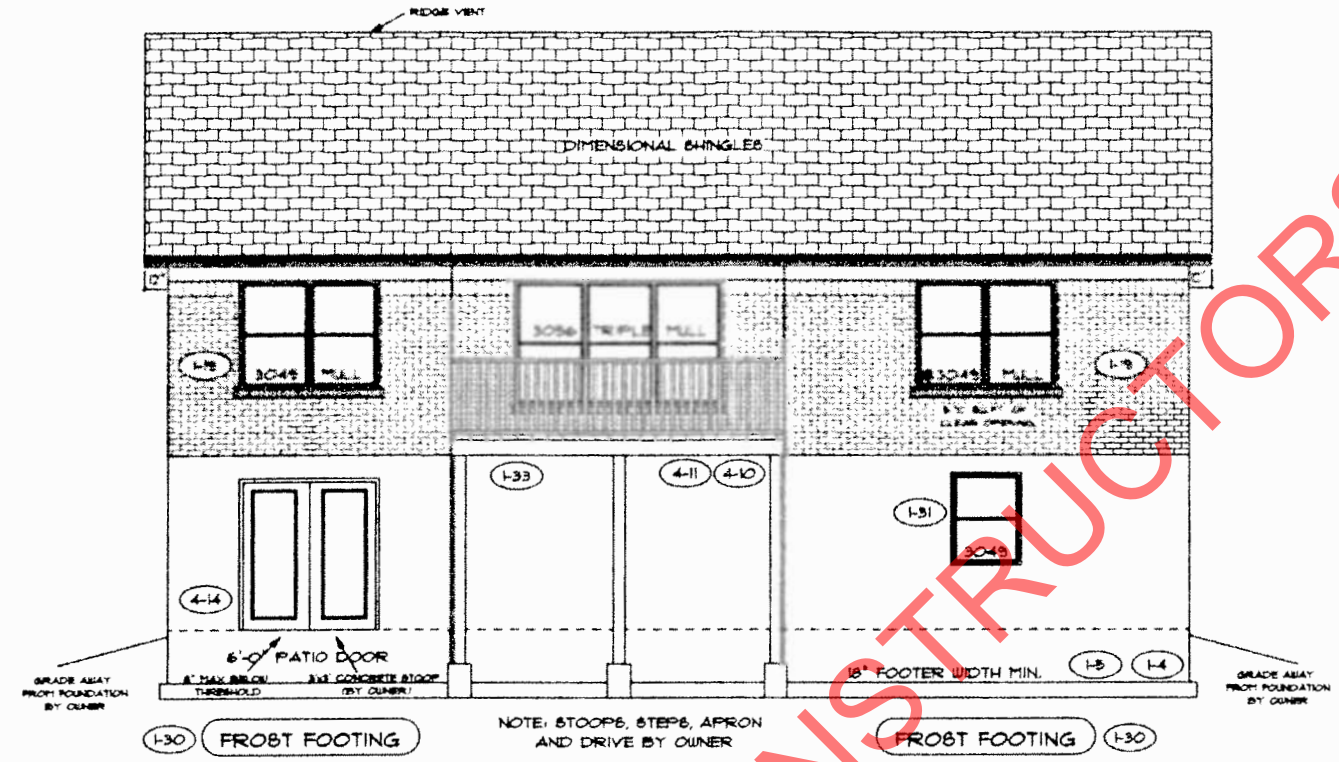

FRONT ELEVATION

PROPERLY OF TK CONSTRUCTORS, INC.

TK CONSTRUCTORS
ROCKFORD

DATE: May 11, 2016
JOB NO.: 212-16-0302

ADDENDUM 1, 4
VER: 10:51 AM
DRAWING BY: GW, SES
1/8" = 1'

PAGE NO.: 1B

WC
JC

FLOOR PLAN

TOTAL LIVING SQ.FT.	1,581
GARAGE	472
TOTAL SQ.FT.	2,053
EXCLUDING PORCH	16
EXCLUDING PORCH	208

ANDERSEN WINDOW SCHEDULE
- 200 SERIES -

ANDERSEN MODEL NO.	R.O. SIZE
3030	36" x 36"
3040	36" x 48"
3049*	36" x 57"
3056*	36" x 66"
3060*	36" x 72"
3049 MULL*	73" x 57"
3056 MULL*	73" x 66"
3060 MULL*	73" x 72"
ANDERSEN SLIDING DOOR R.O. 12 3/4" x 82 7/8"	
3'-0" FRONT DOOR R.O. 38 3/8" x 82 1/2"	
3'-0" FRONT DOOR WITH (1) SIDELITE R.O. 51 7/8" x 82 1/2"	
3'-0" FRONT DOOR WITH (2) SIDELITES R.O. 65 3/8" x 82 1/2"	
R.O. FOR BI-FOLD DOORS USING DRYWALL JAMB FACING = 1 1/4" + DOOR SIZE x (81 1/2")	
R.O. FOR BYPASS DOORS USING DRYWALL JAMB FACING MAKE SAME AS BOTH DOORS ADDED TOGETHER	
ALL INTERIOR DOORS SIZE + 2" TO WIDTH x 82 1/2" HIGH	
R.O. POCKET DOOR (2x DOOR WIDTH + 1") x 85" HIGH	


* - DENOTES OPENING MEETS
EGRESS REQUIREMENTS

ALL WALL DIMENSIONS ARE FACE TO FACE OF STUDS
ALL INTERIOR WALLS ARE 3/2" (UNLESS NOTED)
EXHAUST BATH FANS ARE VENTED TO OUTSIDE AIR
3049 BASH (8.70 SQ.FT. OF CLEAR OPENING)
ALL BRICK LAYOUT MEASUREMENTS ARE 4"

ALL FLOORING, PAINT AND
CAULKING L&M BY OWNER

SMOOTH CEILING

Day Light

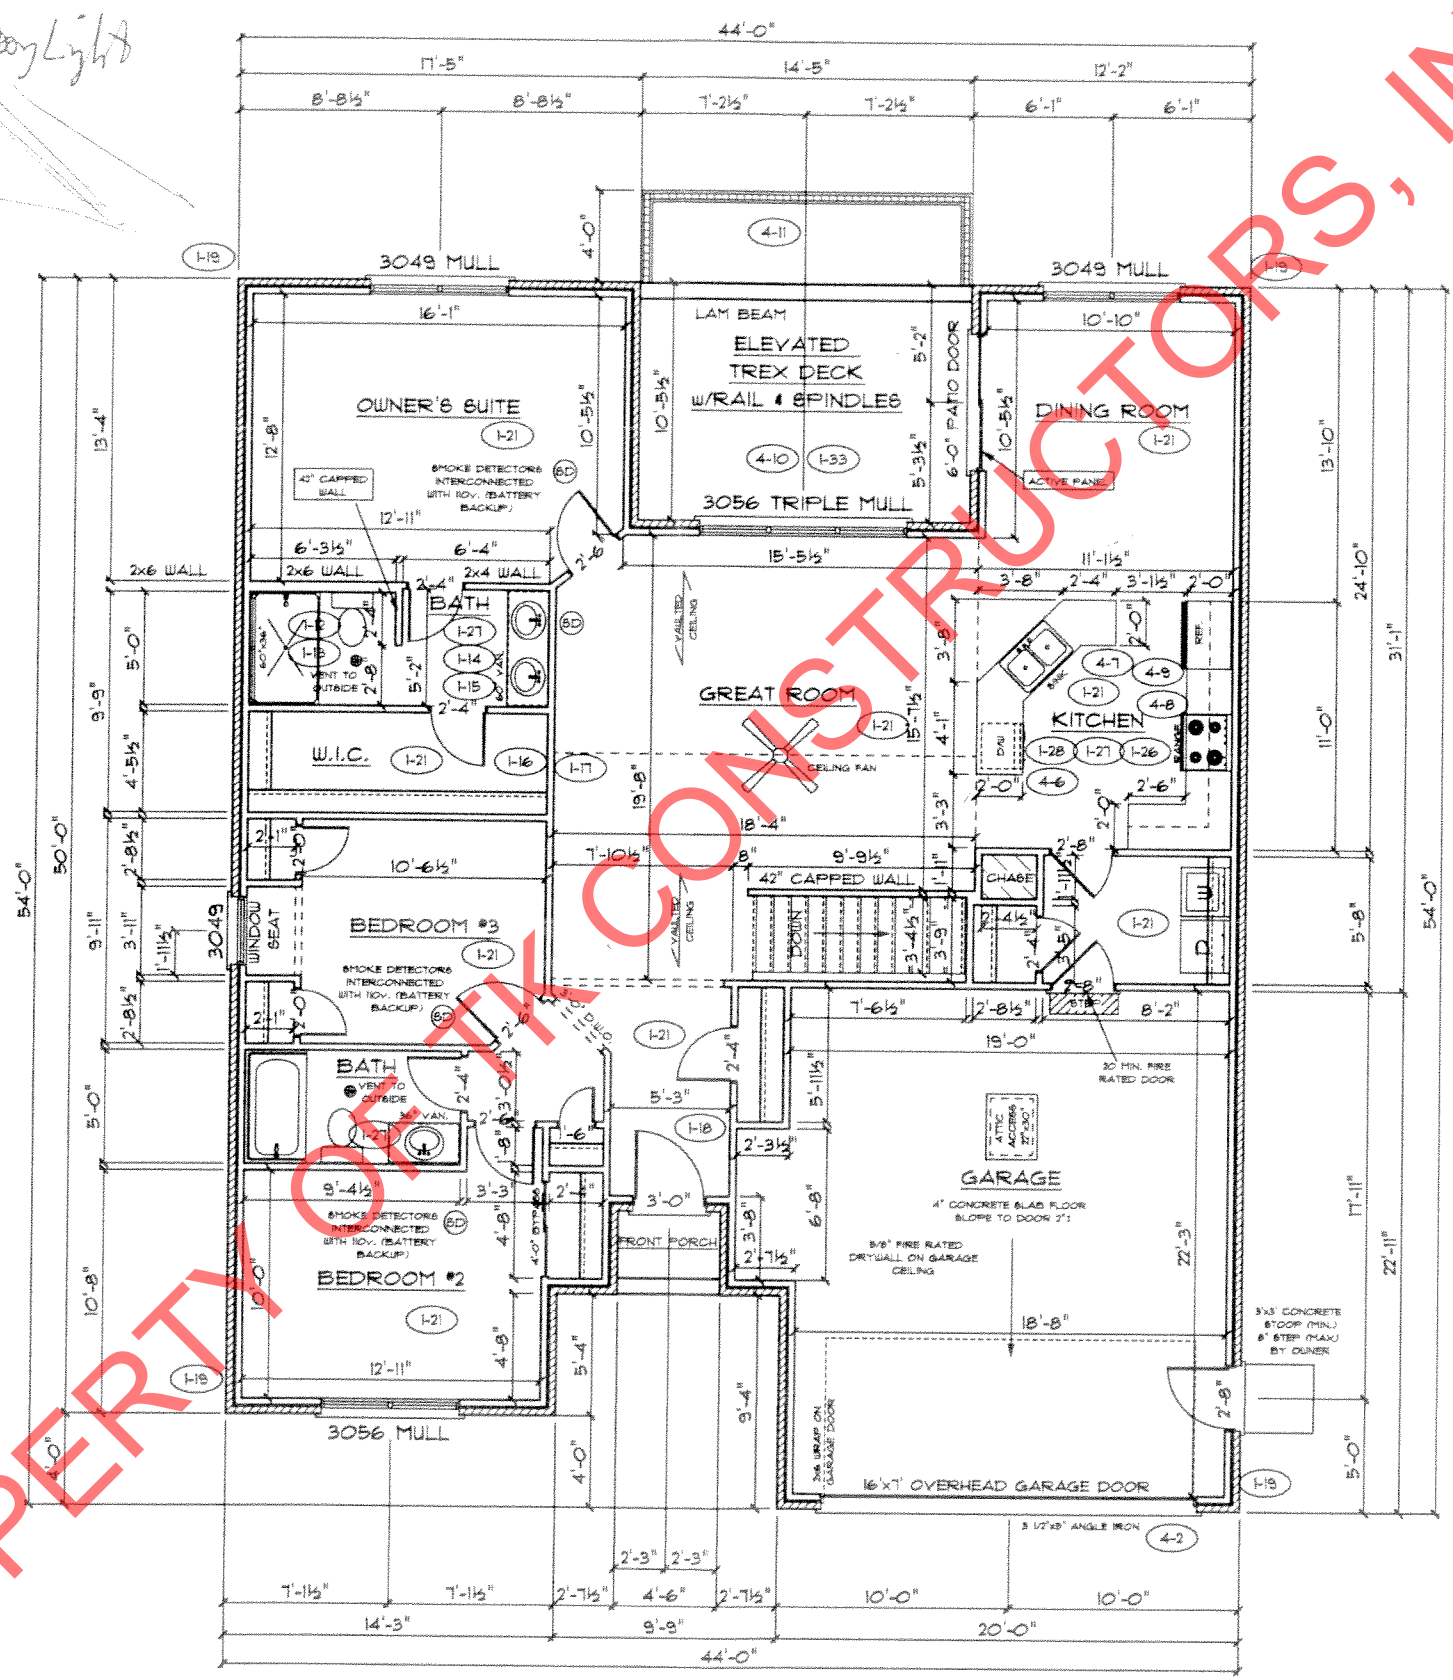

PROPERTY ONLY

wc jc

TK CONSTRUCTORS
ROCKFORD

DATE: May 11, 2016
JOB NO.: 212-16-0302

ADDENDUM 1, 4
VER: 10-57 AM
DRAWING BY: GW, SES
1/8" = 1'

PAGE NO.: 3B